
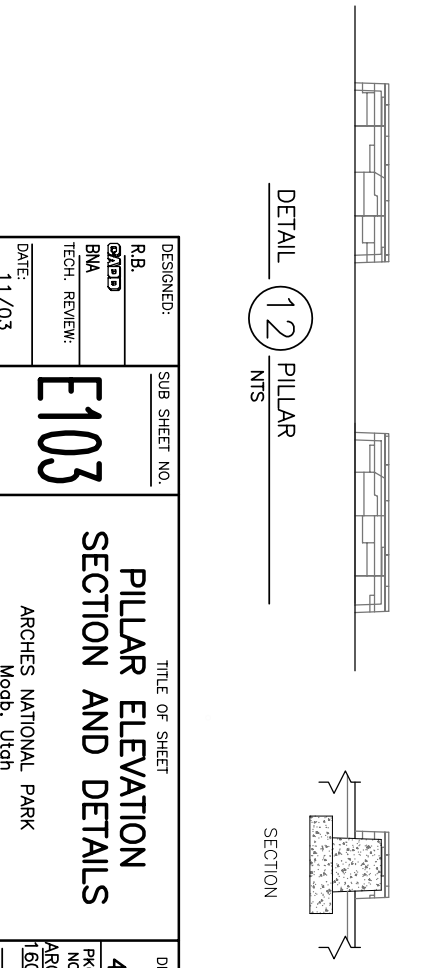
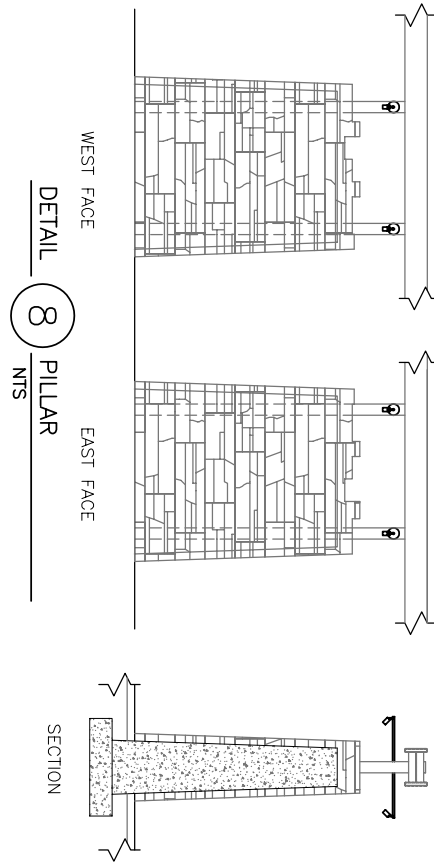
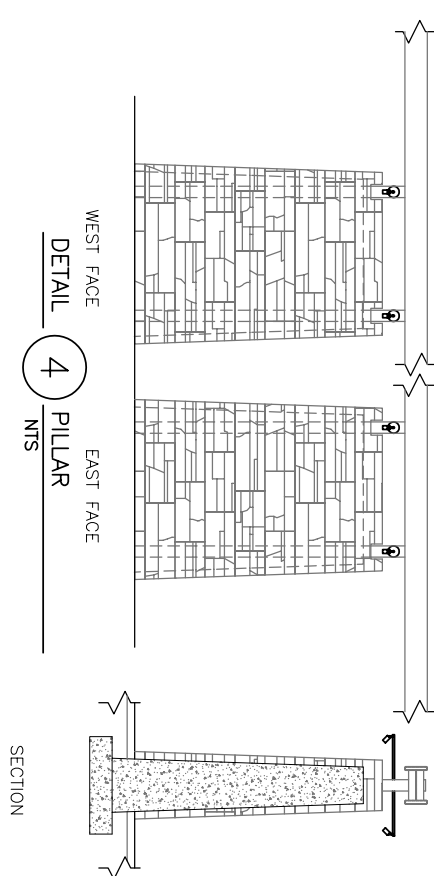
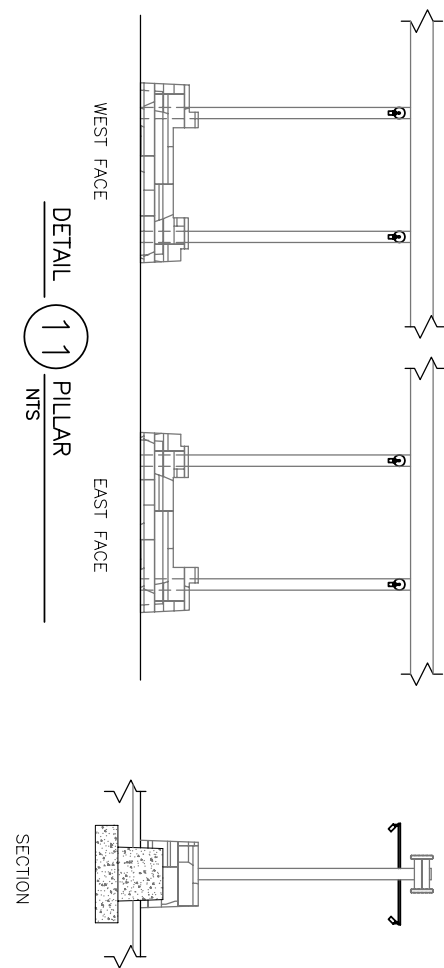
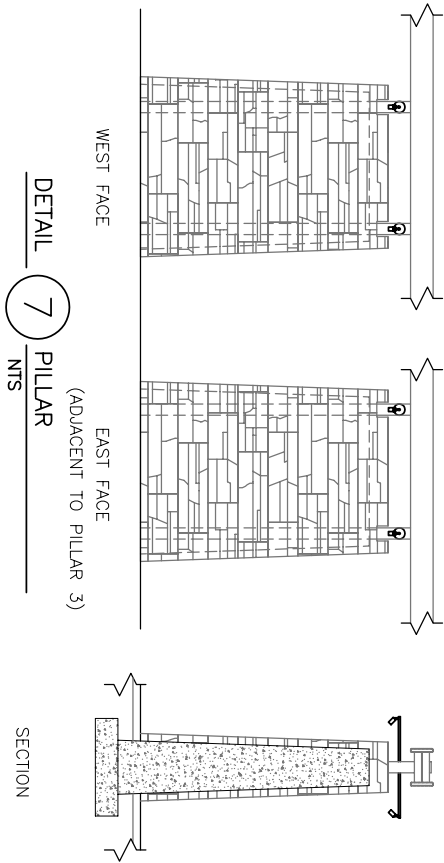
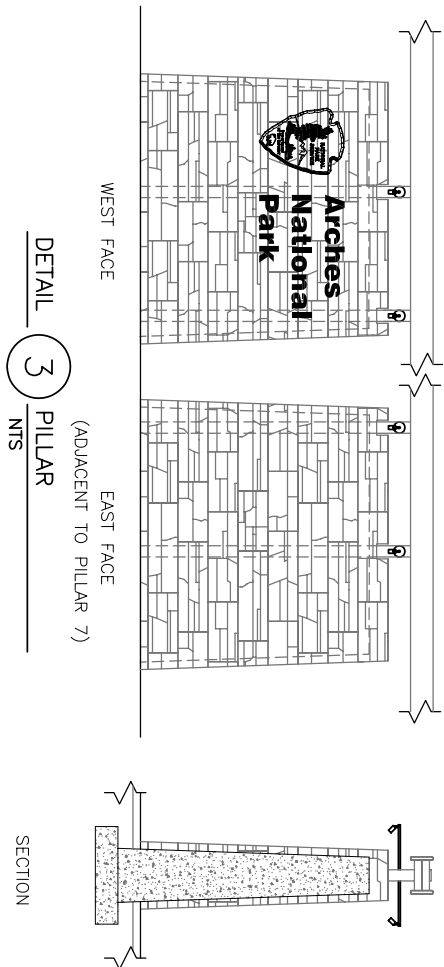
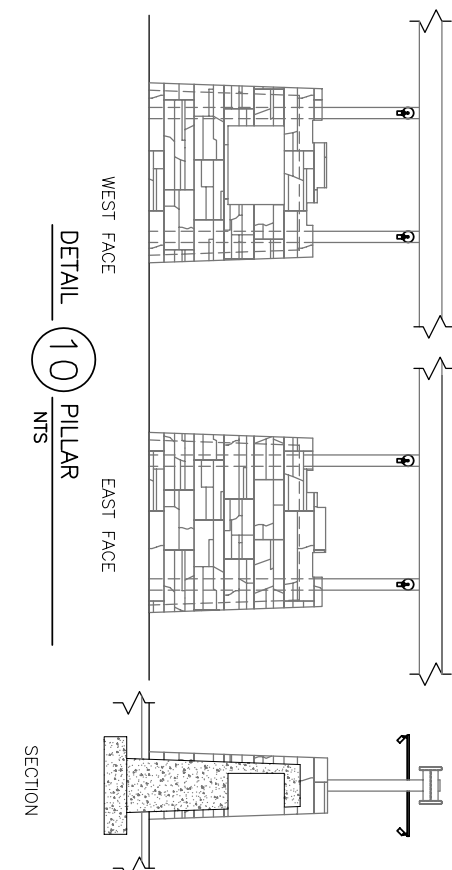
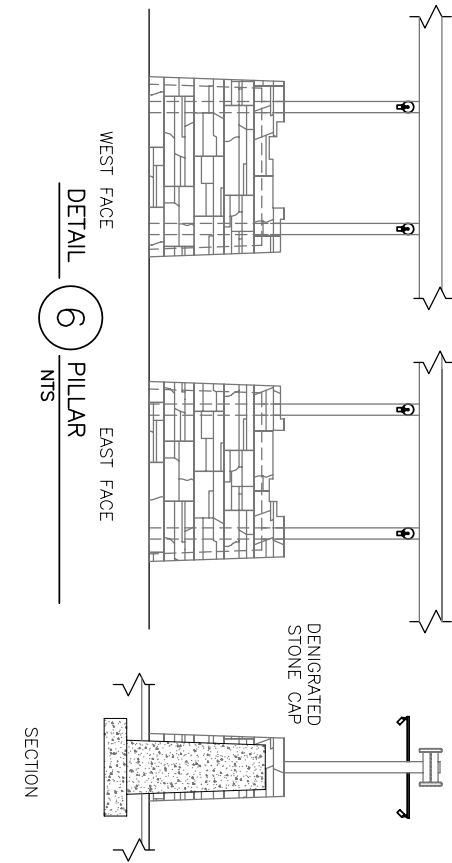
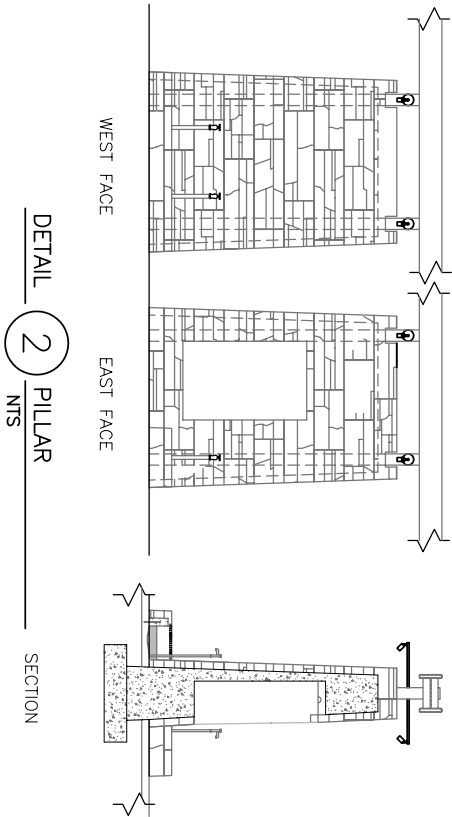
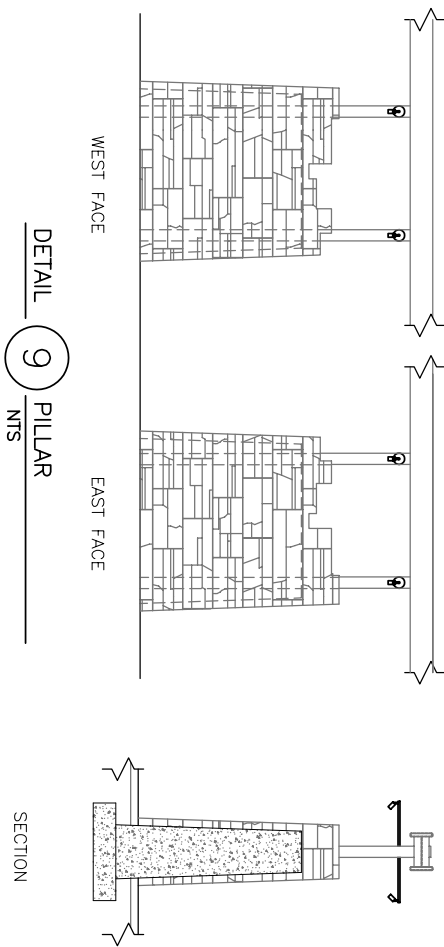
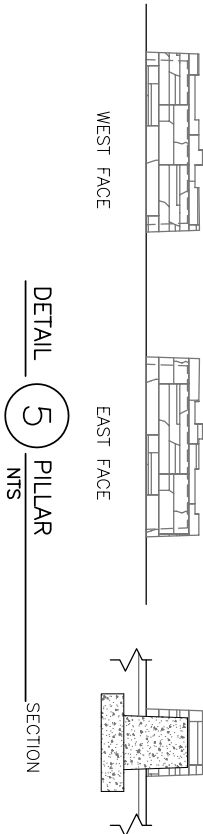


RECORD DRAWING
DATE: 04-27-06
THESE RECORD DRAWINGS HAVE BEEN PREPARED BASED ON INFORMATION PROVIDED BY OTHERS. THE DESIGN PROFESSIONAL HAS NOT VERIFIED THE ACCURACY AND/OR COMPLETENESS OF THIS INFORMATION AND SHALL NOT BE RESPONSIBLE FOR ANY ERRORS OR OMISSIONS WHICH MAY BE INCORPORATED HEREIN AS A RESULT.

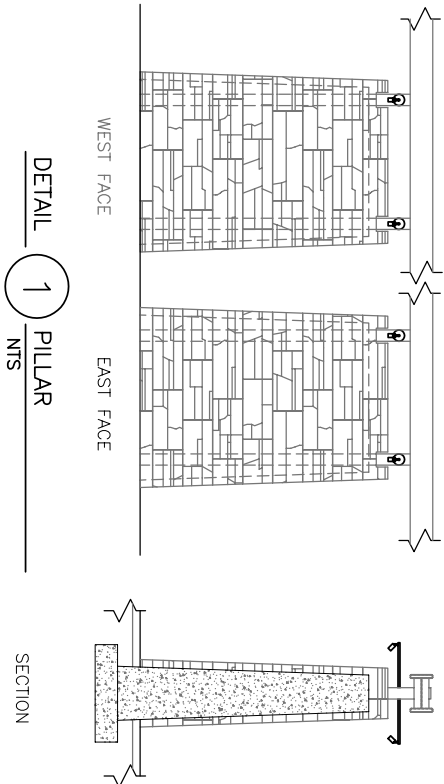

DESIGNED: R.B. BMA	SUB SHEET NO. 41025B	TITLE OF SHEET PILLAR ELEVATION SECTION AND DETAILS	DRAWING NO. 138/
TECH. REVIEW: ARCH 160-		ARCHES NATIONAL PARK Moab, Utah	SHEET 105 of 121
DATE: 11/03			